


2073 Dundas, Cardinal Main level

Commercial

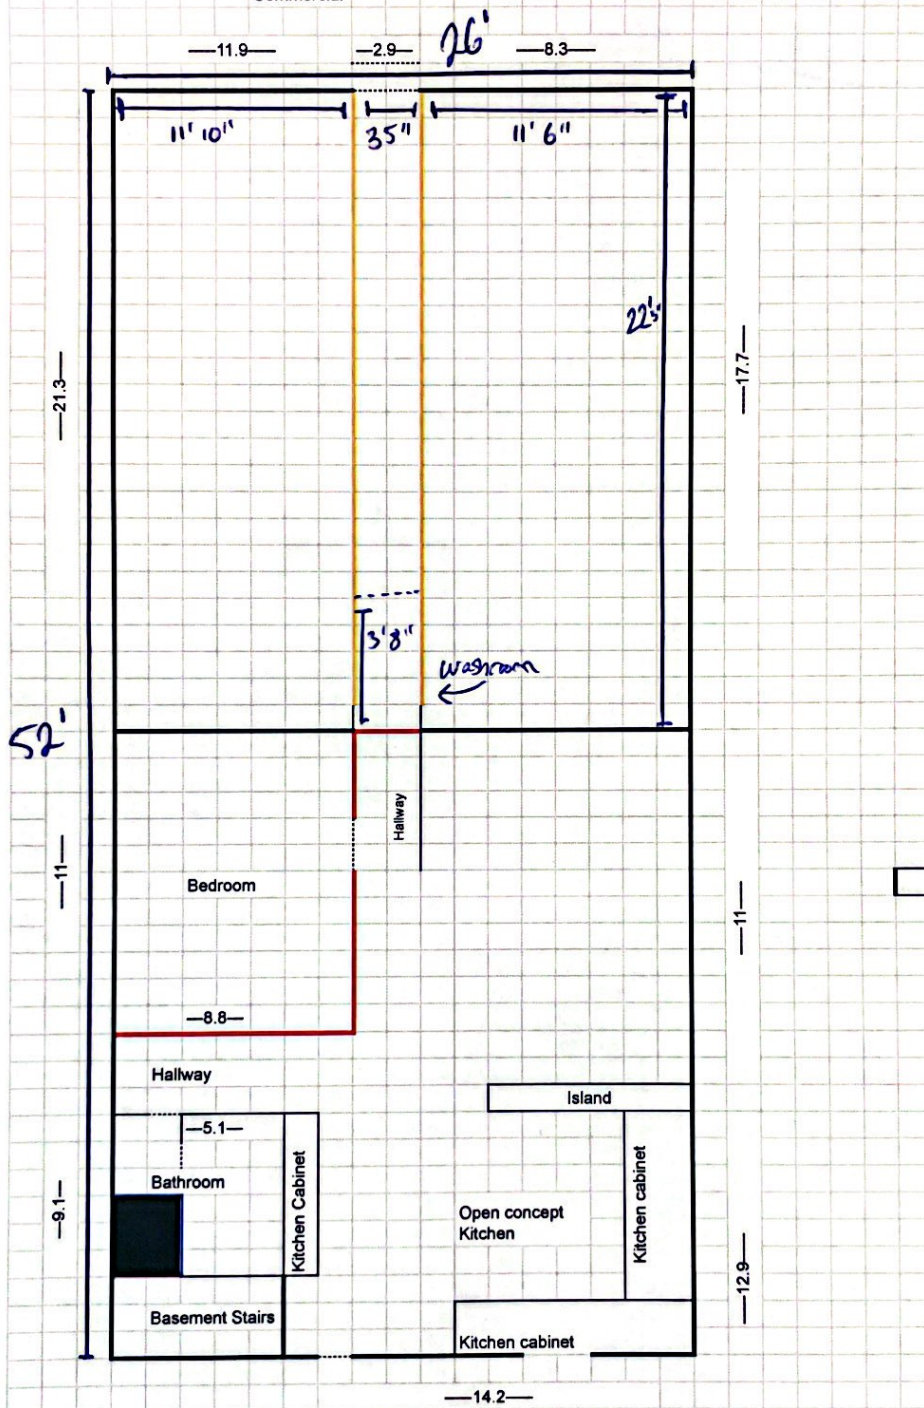

Black space is stairs leading to the upstairs, no access from lower unit

Red lines = New Walls

Commercial space- we would like to remove interior dividing walls. They are not structural. Outlined in Yellow